



C. Earl Hunter, Commissioner

*Promoting and protecting the health of the public and the environment.*

## **PUBLIC NOTICE AMENDMENT REQUEST**

The permittee for P/N# **OCRM-07-873, Elizabeth P Lowndes**, has requested an amendment to that issued permit. Specifically, the applicant proposes to increase the walkway length from 129.17' to 166.10' and delete the catwalk and relocate the boatlift off the pierhead. The proposed amendment is for modifications to private recreational dock, on and adjacent to Jenkins Creek at Lot 16 N Polowana Island, St Helena Island, Beaufort County, South Carolina.

Written comments will be received on this amendment request until February 11, 2008 at the address listed below. For further information please contact the project manager, Geordie J Madlinger, 843-846-9400.


February 1, 2008

**SOUTH CAROLINA DEPARTMENT OF HEALTH AND ENVIRONMENTAL CONTROL**

**Ocean and Coastal Resource Management**

**Beaufort Office • 104 Parker Drive • Beaufort, SC 29935**

**Phone: 843-846-9400 • Fax: 843-846-9810 • [www.scdhec.gov](http://www.scdhec.gov)**

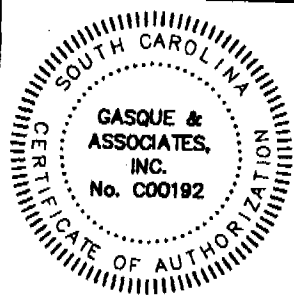


**GASQUE & ASSOCIATES INC.**  
**LAND SURVEYORS & PLANNERS**

28 PROFESSIONAL VILLAGE CIRCLE, BEAUFORT, S.C.  
P.O. BOX 1363, BEAUFORT, S.C.  
PHONE (843) 522-1798

SHEET #1 OF 1

JENKINS CREEK  
FLOOD  
EDG

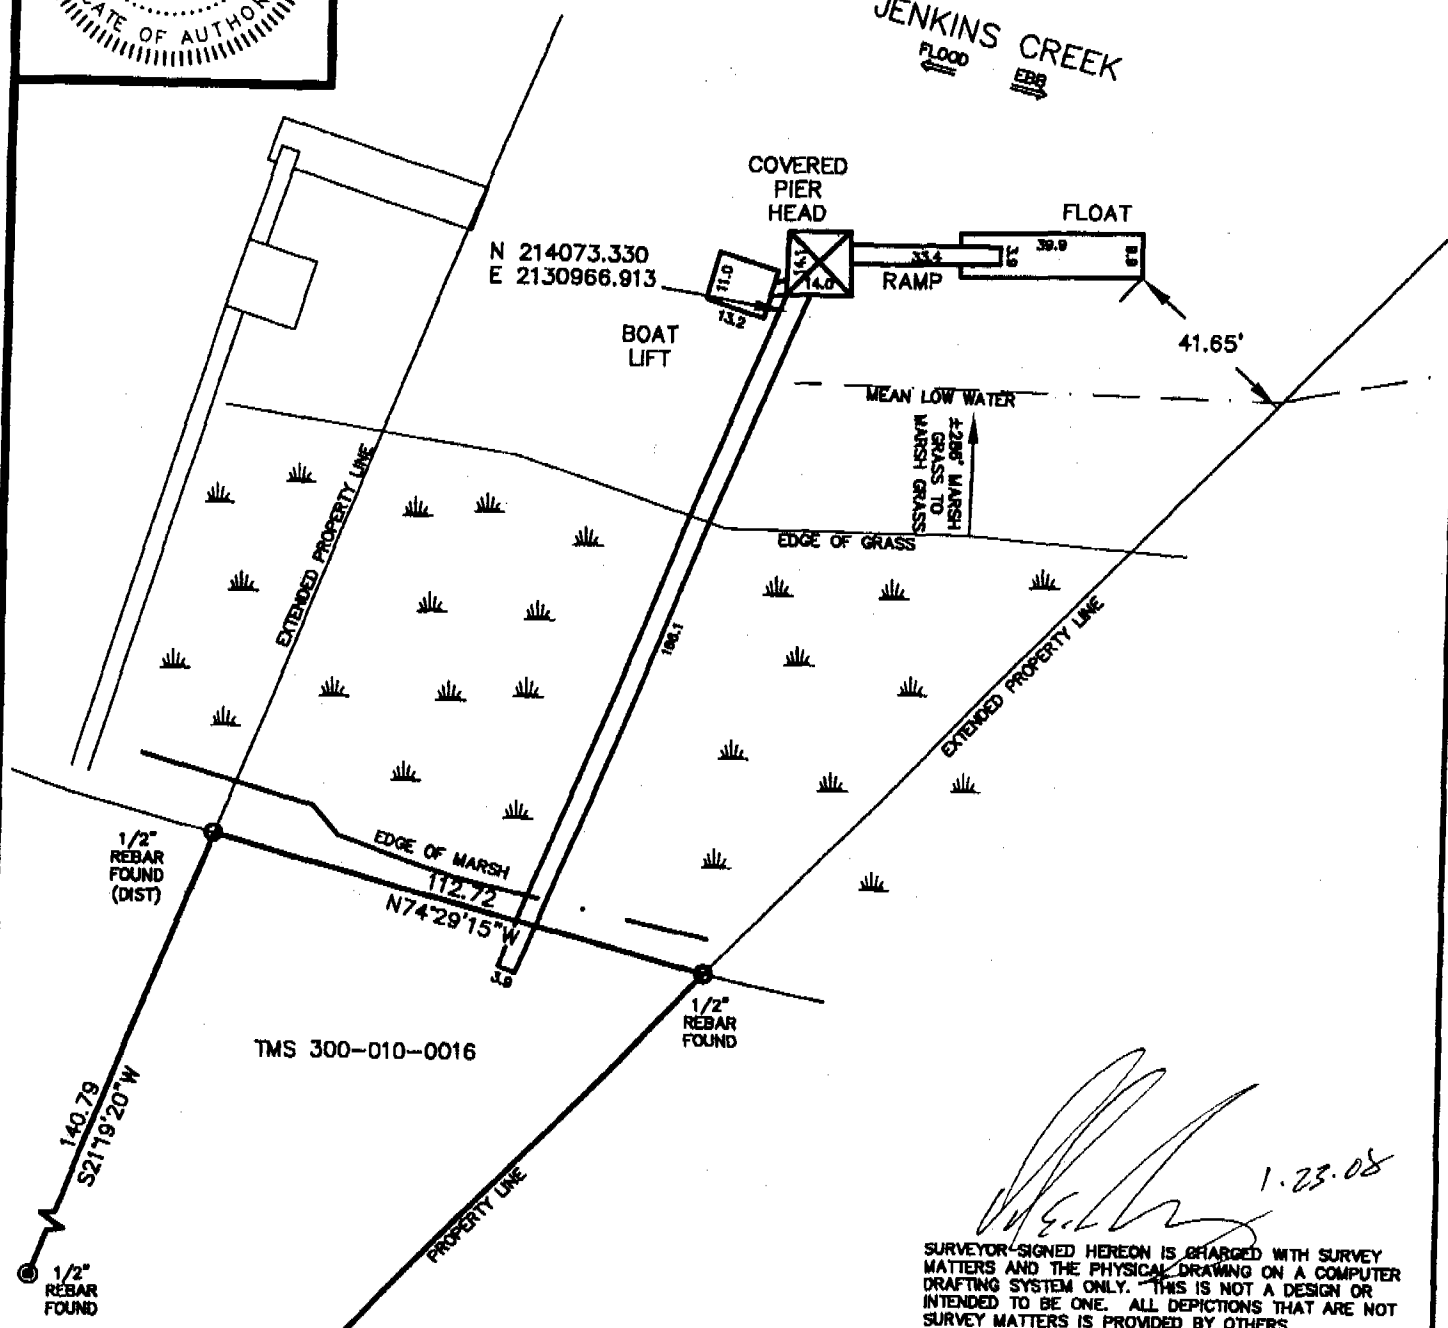

*[Signature]* 1.23.08  
SURVEYOR-SIGNED HEREON IS CHARGED WITH SURVEY MATTERS AND THE PHYSICAL DRAWING ON A COMPUTER DRAFTING SYSTEM ONLY. THIS IS NOT A DESIGN OR INTENDED TO BE ONE. ALL DEPICTIONS THAT ARE NOT SURVEY MATTERS IS PROVIDED BY OTHERS.

DATUM: M.L.W.  
ADJACENT PROPERTY OWNERS:  
1. JAMES McVUTY  
2. LINDA KAYE OWENS  
3. JO ELLA RENTZ  
4. JOHN DANIEL  
5. POLOWANA ISLAND COMMUNITY OWNERS ASSOCIATION

0 20 40 80



SCALE: 1"=40'

O'QUINN MARINE INC.  
95 SHEPPARD ROAD  
BEAUFORT, SC 29907

DOCK AS-BUILT

IN: JENKINS CREEK

AT: POLOWANA ISLAND

COUNTY OF: BEAUFORT  
STATE: SOUTH CAROLINA

APPLICATION BY: O'QUINN MARINE

JOB# 34666 DESIGN 7 DATE: 1/17/08